



CDM

TENNESSEE DEPARTMENT OF ENVIRONMENT AND CONSERVATION
APPLICATION FOR GROUND WATER PROTECTION SERVICES

1. SERVICE REQUESTED: (check service)

APPLICANT
COMPLETE QUESTIONS:

FEE DUE

PTBMIS CODES V689
Code Supp/Code

<input type="checkbox"/> Septic System Construction Permit				
<input type="checkbox"/> Dwelling	2, 3, 4, 7, 8, 9	\$	78064	Yes
<input type="checkbox"/> Commercial: gpd	2, 3, 4, 7, 8, 9	\$	78064	Yes
<input type="checkbox"/> System Modification	2, 3, 4, 7, 8, 9	\$	78064	Yes
<input checked="" type="checkbox"/> Repair	2, 3, 4, 7, 8, 9	\$	78032	
<input type="checkbox"/> Inspection Letter	2, 3, 5, 7, 8, 9	\$	78030	
<input type="checkbox"/> Water Sample				
<input type="checkbox"/> Total Coliform	2, 3, 6, 7, 8, 9	\$	78036	Yes
<input type="checkbox"/> Fecal Coliform	2, 3, 6, 7, 8, 9	\$	78038	Yes
<input type="checkbox"/> Alternative System Permit*		\$	78068	
<input type="checkbox"/> Large Conventional System Plan Review*		\$	78099	
<input type="checkbox"/> Large Alternative System Plan Review*		\$	78099	
<input type="checkbox"/> Experimental System Plan Review*		\$	78072	
<input type="checkbox"/> Subdivision Evaluation: Lots: *		\$		
<input type="checkbox"/> Soil Mapping: Type _____ Acres _____ *		\$		Yes
<input type="checkbox"/> Installer Permit: Type(s) _____ *		\$	78026	Yes
<input type="checkbox"/> Pumper Permit*		\$	78028	
<input type="checkbox"/> Plat Approval — Individual Lot		\$	78029	
<input type="checkbox"/> Domestic Septage Disposal Site Permit		\$	78031	

*Applicant may review these service requests with Environmental Specialist prior to processing application.

2. LANDOWNER:

Names: Willie Huddleston
Address: 3298 Poplar Grove

APPLICANT

Name: _____
Address: _____

ORIGINAL OWNER

Name: _____

Day Phone: 526-1345

Day Phone: _____

3. LOCATION OF LOT OR SITE: a) In a subdivision? _____ b) Name: _____ Lot # _____
b) Non-Subdivision _____ Give specific directions and address to the lot or site: _____

4. FOR SSDS PERMIT ONLY: a) Size of lot _____ b) Number of Bedrooms _____
c) How many occupants? 2 d) Excavated Basement? Yes _____ No _____
e) Basement Plumbing Fixtures? Yes ☒ No _____
f) Amount of water used monthly (gallons) _____
g) Water Supply: Public _____ Well _____ Spring _____
h) Is the lot staked? _____ If not, date it will be staked: _____
Is the house staked? _____ If not, date it will be staked: _____
i) Installer, if known: _____

5. FOR INSPECTION LETTER ONLY: Will pick up _____ Please mail _____ *slow working*
a) Age of house _____ b) Is house vacant? _____ How long? _____
c) Original sewage system inspected by Health Department? _____
d) Date of previous repairs _____ Inspected _____
e) Is waste water "backing up" into plumbing fixtures? _____ Surfacing on the ground? _____
f) All waste water including washing machines routed into septic tank _____
6. FOR WATER SAMPLE ONLY: a) Source of Supply: Spring _____ Well _____
b) Is there an outside faucet? _____ c) Is the source chlorinated? _____
d) For Wells: Is the casing 6" above the ground? _____ Is a sanitary seal on the casing? _____
7. MAKE A ROUGH SKETCH ON BACK OF THIS **WHITE** PAGE SHOWING DIRECTIONS TO PROPERTY, PROPERTY LINES, HOUSE SITE, WELL LOCATION, SPRING LOCATION, PLANNED DRIVEWAY AND UTILITIES.
8. ALL FEES DUE IN ADVANCE AND ARE NON-REFUNDABLE (except upon appeal). See Fee Schedule on reverse. Make check payable to: **TREASURER, STATE OF TENNESSEE**
9. I certify that the above information is true and correct to the best of my knowledge, and that I have been authorized by the above named landowner to submit this Application for Environmental Services to the Division of Ground Water Protection.

DATE: 9-27-00 SIGNATURE: [Signature] AMOUNT PAID: \$ [Signature] RECEIPT NUMBER NA

White: File

Canary: Owner

PERMIT FOR CONSTRUCTION OF SUBSURFACE SEWAGE DISPOSAL SYSTEM

☒ Standard System (01.1)
 ☐ Alternating System (01.2)
 ☐ Other (01.3)

Issued To: (02.) Willie Hodgeson
(Owner, Developer, Contractor, Installer, Etc.)

To Be Constructed By: (03.) Earnest Lee
(Installer)

Construction of a subsurface sewage disposal system consisting of a septic tank and underground disposal field, or (04.) gravel pit is hereby authorized at (05.) Home across street from Postle
(Other Approved System) (Property Address - No. and Street - Subdivision Name and Lot No., Etc.)

Such system shall consist of a septic tank of (06.) 1000 gallons liquid capacity with (07.) 300 linear feet of field line in (08.) 3 trenches (09.) 36 inches wide and (10.) 30 deep, or (11.) _____
(Description of Other Approved System)

designed for (12.1) 1 Residential (12.2) 3 Home or (13.1) _____ Commercial or Industrial (13.2) _____
(No. of Bedrooms) (Gal. per Day)


The recipient of this permit agrees to construct or have constructed the system in accordance with the rules and regulations under the authority of TCA 53-2042 thru 53-2054. The recipient must notify the local health authority when the system is ready for inspection. If any part of the system is covered before being inspected and approved, it shall be uncovered by the recipient of the permit at the direction of the local health authority.

(14.) _____ Date (15.) 8-30-76
(Signature of Recipient—Owner, Developer, Contractor, Etc.)

Issued at (16.) Cookeville, Tennessee in the County of (17.) Putnam

(18.) _____, Local Health Authority Date (19.) 9-30-76

Sketch of System By: (20.) Neil Hall

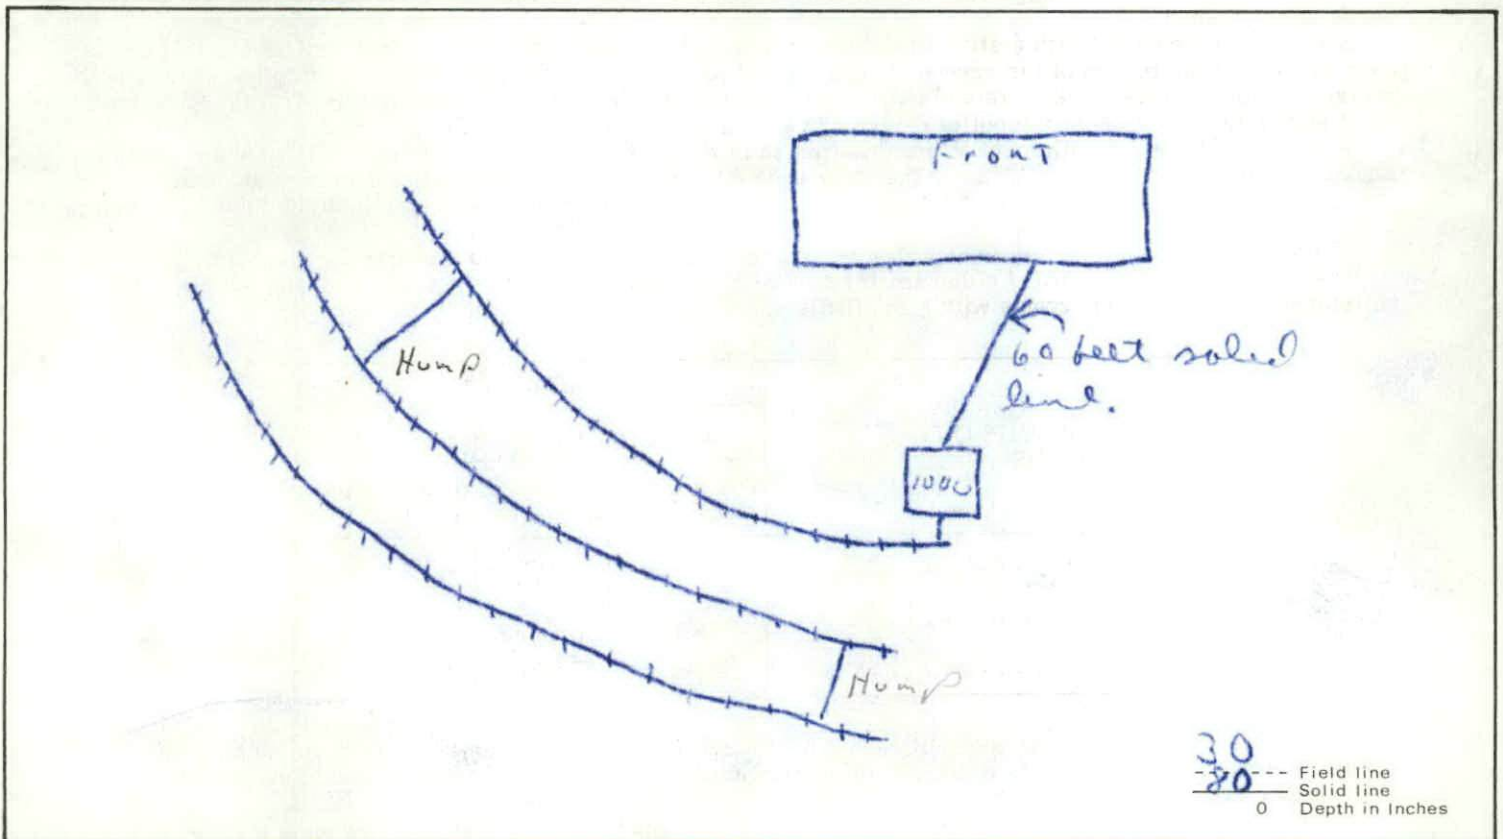

(21.) Construction Approval: Yes ☒ No _____ Date (22.) 8-23-76 Inspected By (23.) Neil Hall
(Local Health Authority)

(24.) Provisions of Sewage Regulations Met: Yes _____ No _____

(25.) Remarks: _____

FIRST VISIT ☒ SUBSEQUENT VISIT ☐ UNKNOWN ☐

SANITATION INSPECTION REPORT

CODES TAKEN

☒

☐

☐

Possible Trailer Park

TYPE OF ESTABLISHMENT

OWNER Willie Huddleston ADDRESS _____

NAME OF ESTABLISHMENT _____

LOCATION _____

~~Poplar~~ Poplar Grove Rd on left, 10th Ave

CIVIL DISTRICT _____

OCCUPANT _____ ADDRESS _____

PERSON(S) CONTACTED Mr. Huddleston

PURPOSE OF VISIT Trailer Park

REMARKS

Looking at land for trailer park. I discussed rules & regulations and problems of trailer park with Mr. Huddleston. office & field.

DATE 6-18-74

C. D. McBerry

SIGNATURE